



T.A.A. 941103
 CANTOR FITZGERALD
 A-105

415-45'
 3/20/95
 A-6NW

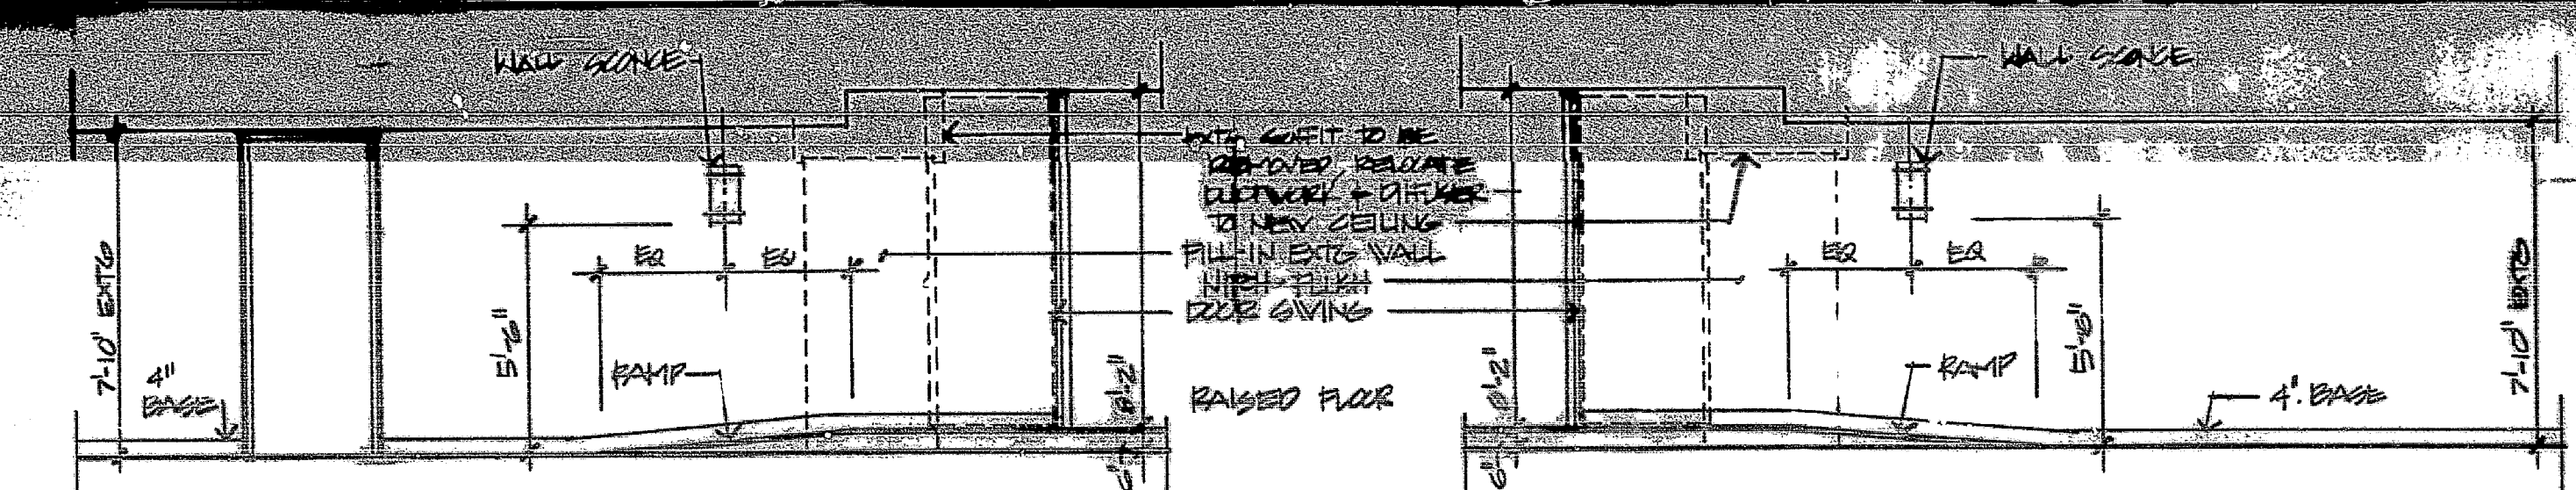


7 CORRIDOR 10524 SOUTH ELEVATION
 SCALE 1/4" = 1'-0"


8 CORRIDOR 10524 NORTH ELEVATION
 SCALE 1/4" = 1'-0"

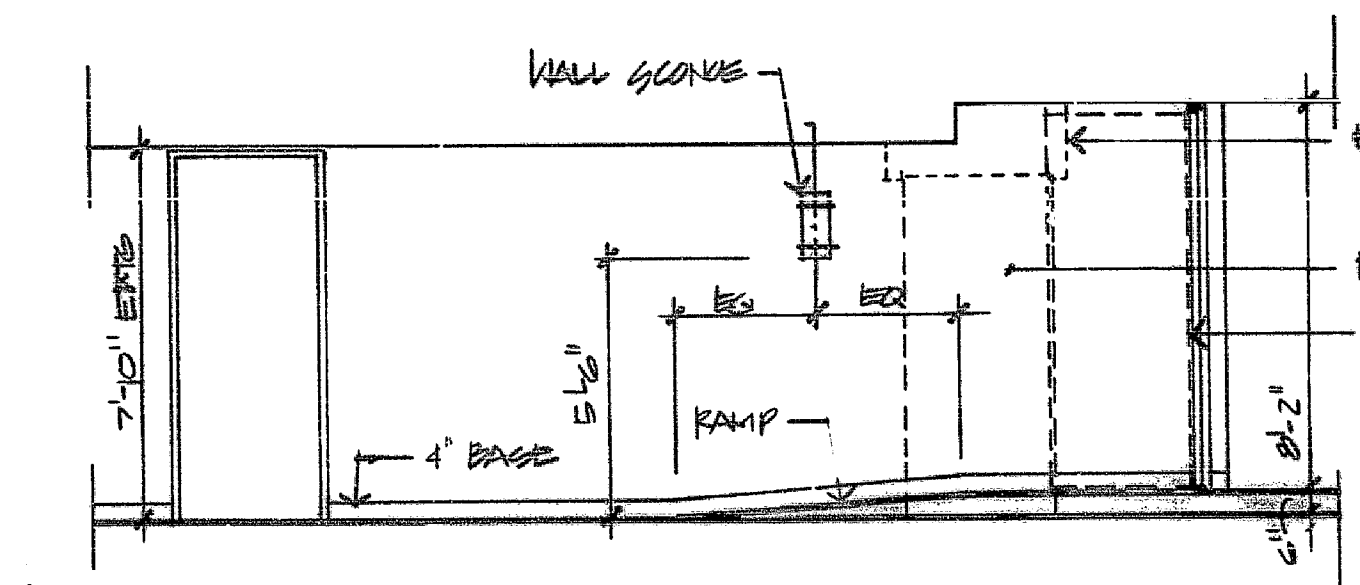


5 CORRIDOR 10526 SOUTH ELEVATION
 SCALE 1/4" = 1'-0"

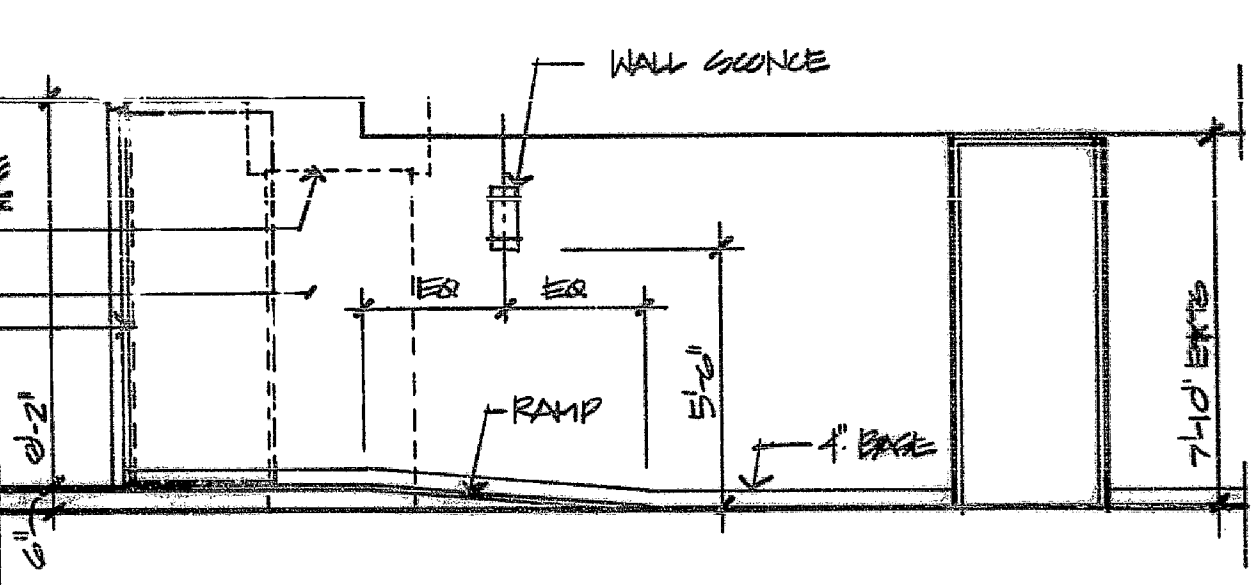


6 CORRIDOR 10526 NORTH ELEVATION
 SCALE 1/4" = 1'-0"

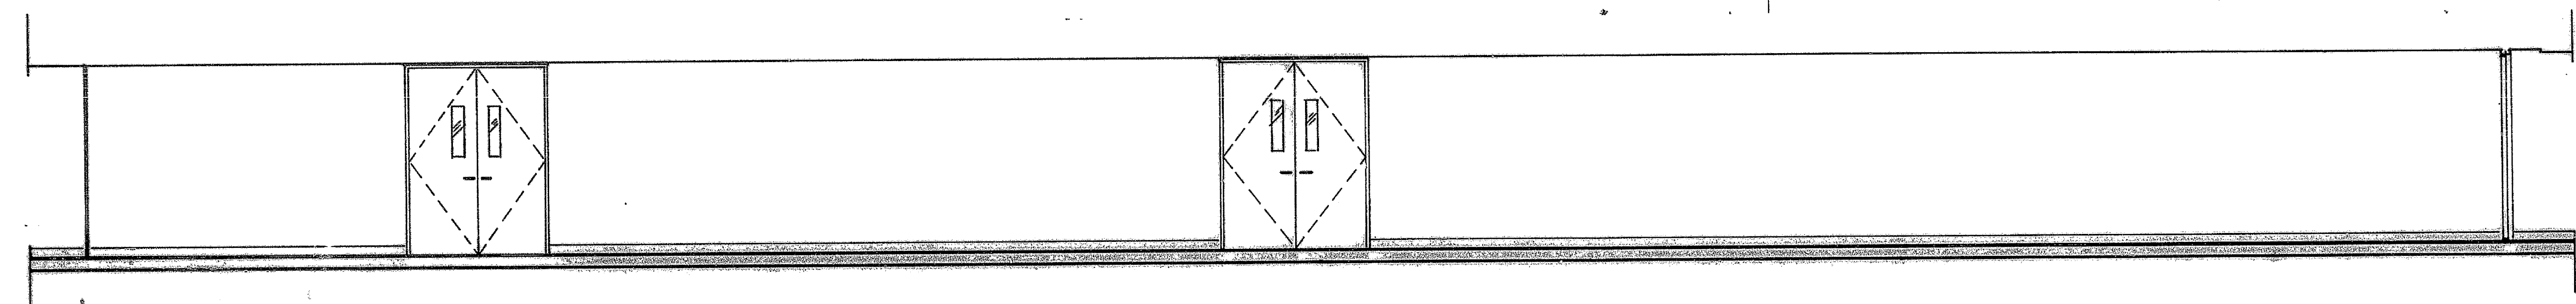


4 ROOM 10525 EAST ELEVATION
 SCALE 1/4" = 1'-0"

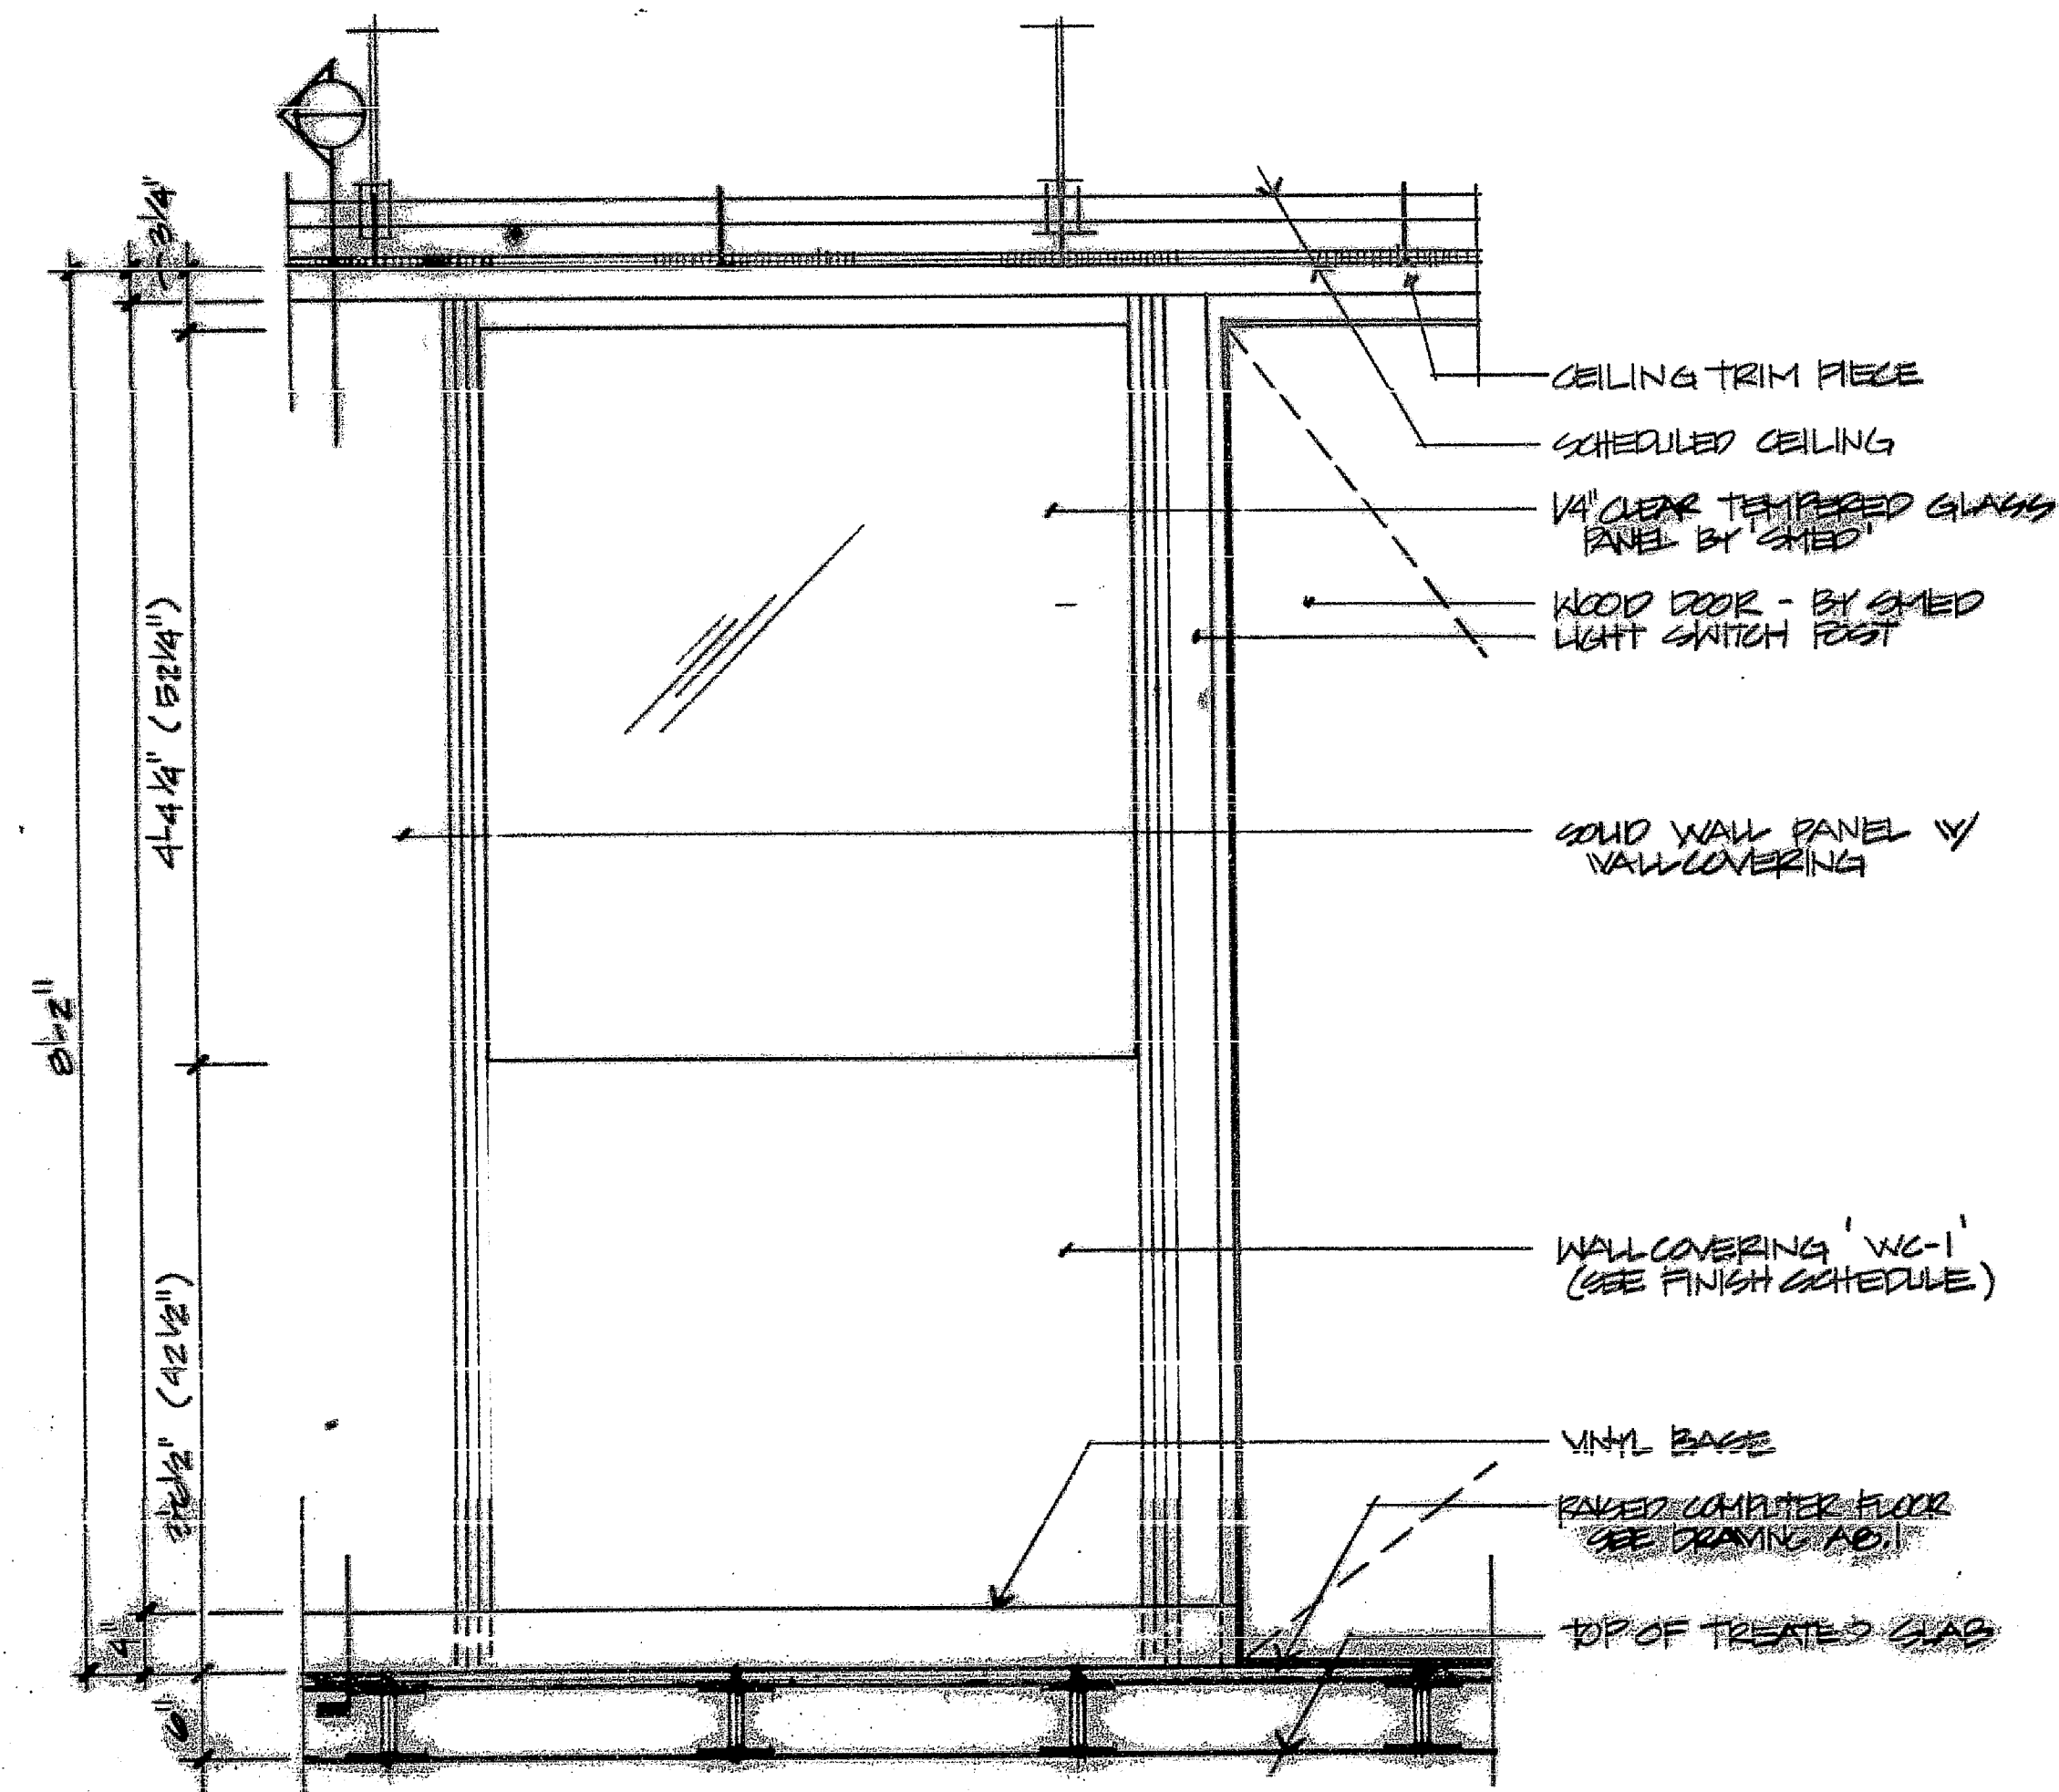

A DETAIL ELEVATION MOVABLE PARTITION
 SCALE 3/4" = 1'-0"

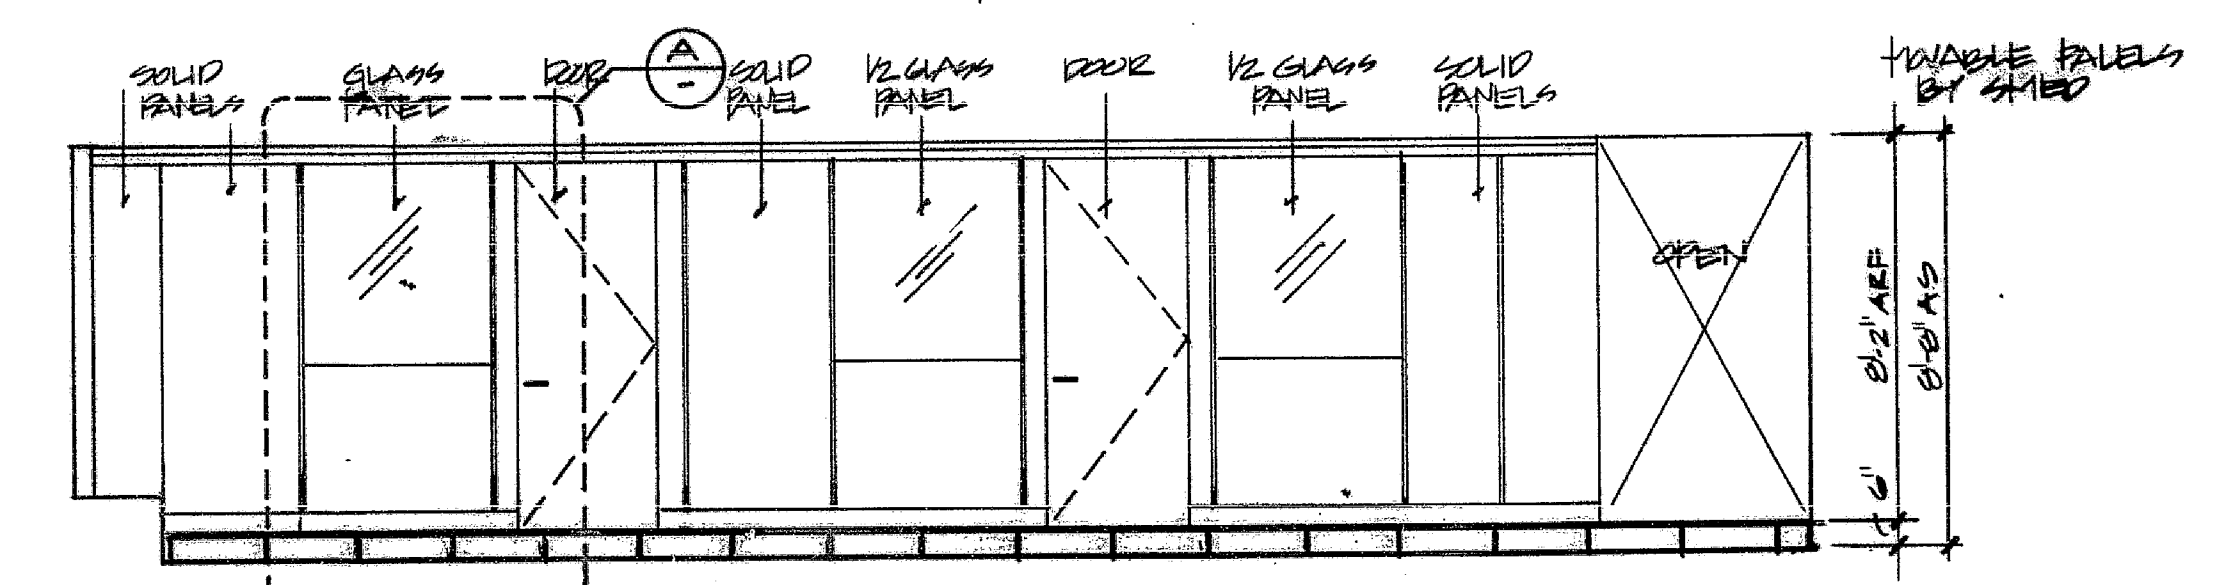

2 ROOM 10525 NORTH ELEVATION
 SCALE 1/4" = 1'-0"

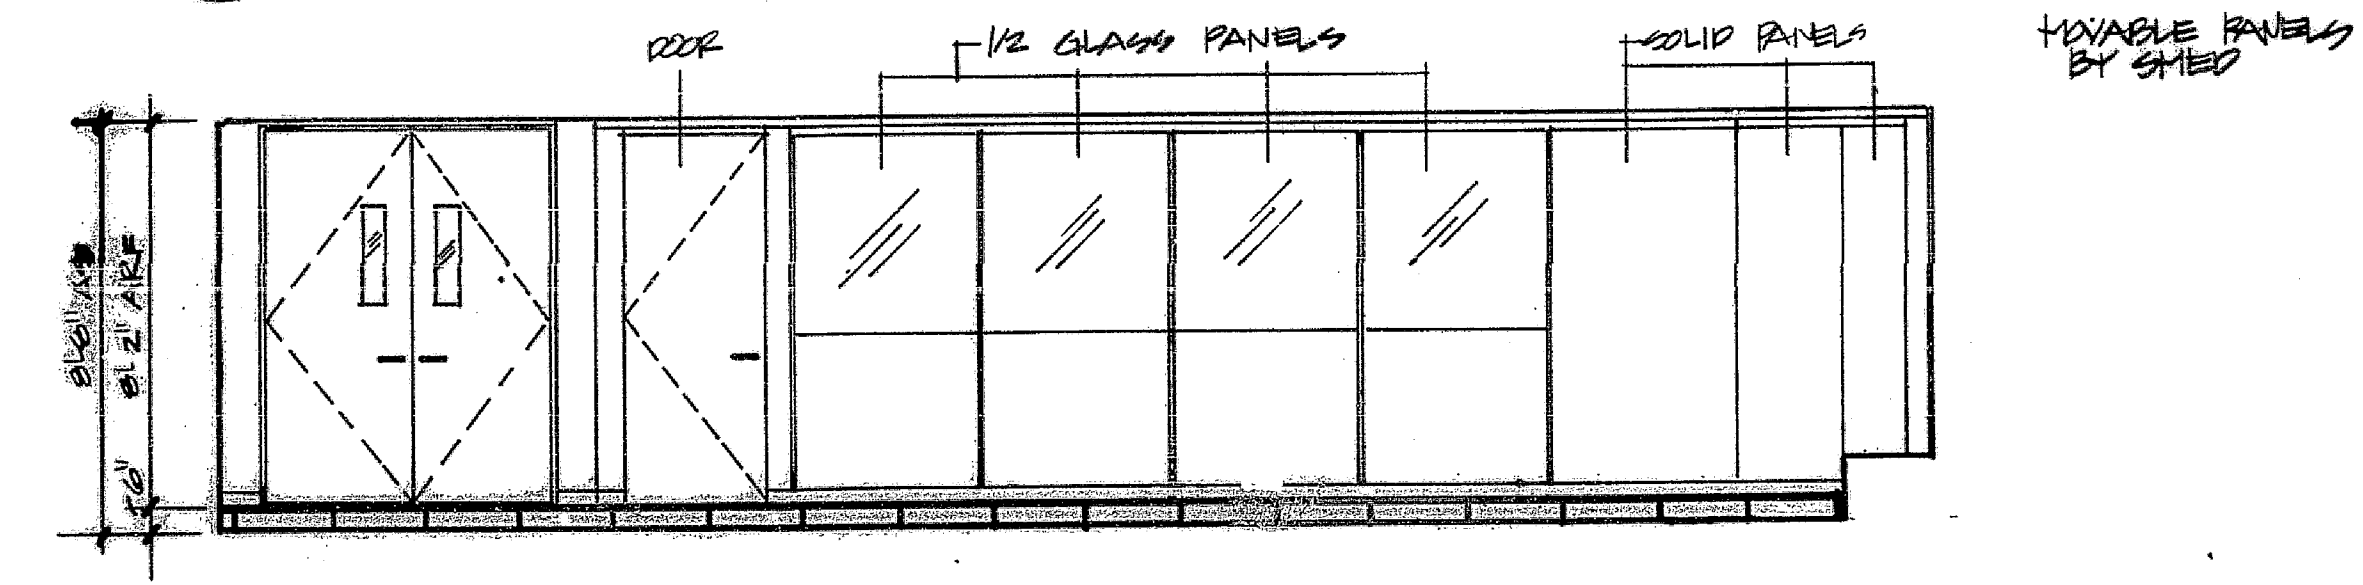

1 ROOM 10525 SOUTH ELEVATION
 SCALE 1/4" = 1'-0"

CANTOR FITZGERALD

WFG DESIGN GROUP
 ARCHITECTS
 INTERIOR DESIGNERS
 255 FIFTH AVENUE
 NEW YORK, NEW YORK 10017
 212 684-1111

General Contractor
 CERTIFIED AS-BUILT

| No. | Revision Date | Issued Record |
|---------|--|---------------|
| | | O M S CM |
| 2.8.94 | REVISED PER PORT AUTHORITY OF NY & NJ COMMENTS | |
| 2.15.94 | REVISED PER CLIENT REQUEST | |
| 6.15.94 | REVISED PER PORT AUTHORITY OF NY & NJ COMMENTS AND TENANTS REQ'D REVISIONS | |
| 2.22.95 | REVISED AS PER PORT AUTHORITY OF NY & NJ COMMENTS | |
| 3.20.95 | REVISED AS PER PORT AUTHORITY OF NY & NJ COMMENTS | |

INTERIOR ELEVATIONS

| | |
|-----------------------|------------------|
| Scale SEE DETAIL | Drawn By D.M. |
| Project No. 941103 | Date 3.15.95 |
| | Dwg. No. |

REGISTERED ARCHITECT
 CHRISTOPHER L. CURE
 1992
 STATE OF NEW YORK
 A-6NW